

CITY OF BASTROP, TX

RESOLUTION NO. R-2026-48

A RESOLUTION OF THE CITY OF BASTROP, TEXAS, APPROVING A CONSTRUCTION CONTRACT WITH TEXAS UTILITIES (CORIX) FOR A NOT-TO-EXCEED AMOUNT OF ONE HUNDRED SIXTY-FOUR THOUSAND, THREE HUNDRED, SEVENTY DOLLARS AND ZERO CENTS (\$164,370.00) FOR THE TEXAS UTILITIES (CORIX) FORCE MAIN EXTENSION SERVING THE VAL VERDE SUBDIVISION AS ATTACHED IN EXHIBIT A; AUTHORIZING THE EXECUTION OF ALL NECESSARY DOCUMENTS; PROVIDING FOR FINDINGS OF FACT, REPEALER, SEVERABILITY, EFFECTIVE DATE, PROPER NOTICE, AND MEETING

WHEREAS, the City Council of the City of Bastrop, Texas has appointed the City Manager as the Chief Administrative Officer of the City; and

WHEREAS, the City Manager is responsible for the proper administration of all affairs of the City; and

WHEREAS, the total cost of the contract shall not exceed One Hundred Sixty-Four Thousand, Three Hundred, Seventy Dollars and Zero Cents (\$164,370.00); and

WHEREAS, the City Council of the City of Bastrop finds that entering into a construction contract with Texas Utilities (Corix) is in the best interest of the City.

NOW, THEREFORE, BE IT RESOLVED by the City Council of the City of Bastrop, Texas:

Section 1. Findings of Fact: The foregoing recitals are incorporated into this resolution ("Resolution") by reference as findings of fact as if expressly set forth word-for-word herein.

Section 2: That the City Manager is hereby authorized to execute a construction contract with Texas Utilities (Corix) for a not-to-exceed amount of One Hundred Sixty-Four Thousand, Three Hundred, Seventy Dollars and Zero Cents (\$164,370.00), herein attached as Exhibit A.

Section 3: All orders, ordinances, and resolutions, or parts thereof, which are in conflict or inconsistent with any provision of the Resolution are hereby repealed to the extent of such conflict, and the provisions of the Resolution shall be and remain controlling as to the matters resolved herein.

Section 4. Repealer: To the extent reasonably possible, resolutions are to be read together in harmony. However, all resolutions, or parts thereof, that are in conflict or inconsistent with any provision of this Resolution are hereby repealed to the extent of such conflict, and the provisions of this Resolution shall be and remain controlling as to the matters regulated.

Section 5. Severability: Should any of the clauses, sentences, paragraphs, sections, or parts of this Resolution be deemed invalid, unconstitutional, or unenforceable by a court of law or administrative agency with jurisdiction over the matter, such action shall not be construed to affect any other valid portion of this Resolution.

Section 6. Effective Date: This Resolution shall take effect upon the date of final passage noted below, or when all applicable publication requirements, if any, are satisfied in accordance with the City's Charter, its Code of Ordinances, and the laws of the State of Texas.


Section 7. Proper Notice & Meeting: It is hereby officially found and determined that the meeting at which this Resolution was passed was open to the public, and that public notice of the time, place, and purpose of said meeting was given as required by the Open Meetings Act, Texas Government Code, Chapter 551. Notice was also provided as required by Chapter 52 of the Texas Local Government Code.

DULY RESOLVED AND ADOPTED by the City Council of the City of Bastrop, Texas this 14th day of April, 2026.

APPROVED:

By 
Ishmael Harris, Mayor

ATTEST:


Michael Muscarello, City Secretary

APPROVED AS TO FORM:


City Attorney
Denton Navarro Rocha Bernal & Zech, P.C.



3/12/26



Kimley-Horn
5301 Southwest Parkway
Building 2, Suite 100
Austin, TX 78735

RE: Force Main Extension to Existing Val Verde Structure.

As requested, Reynolds has developed a cost proposal to install fittings, valves and piping to relay wastewater to an existing manhole structure on the east side of FM 969 near the Valverde housing addition entrance. Scope of work includes installing a wye fitting and two valves upstream of the new polymer manhole on the FM 969 project, open cut installation of approximately 900' of 10" HDPE force main and connecting to an existing manhole.

Reynolds is proposing to hold the open cut pricing currently being offered on the FM 969 project. This per foot price would include the above-mentioned scope of work excluding the gate valve material, the manhole coring and epoxy lining repair and the exploratory excavation mentioned within the request for quote. Please see the cost breakdown below.

900' of 10" Force Main Installation	\$ 143.00 / ft.	\$ 128,700.00
2 – 10" Gate Valves	\$ 3,335.00 / ea.	\$ 6,670.00
Exiting MH Coring & Epoxy Repair	\$ 4,000.00	\$ 4,000.00
Exploratory Excavation at Existing MH	\$ 5,000.00	\$ 5,000.00
	Total Proposed Cost	\$ 144,370.00

Clarifications :

- A) Pricing based on marked-up drawings sent on 2/26/26.
- B) Material budgets are based on current commodity prices and are subject to fluctuations.
- C) We assume the design details of the current FM 969 project are applicable to this work (bedding, restraint, etc.)



Please contact me with any questions or concerns.

Respectfully,

A handwritten signature in blue ink that reads "Justin Morgan".


Justin Morgan
Project Manager
Reynolds Construction, LLC
6225 N County Road 75 E | Orleans, IN | 47452
Office: 812-666-3690 | Cell: 812-653-9838
justin.morgan@reynoldscon.com | www.reynoldscon.com

This is for initial pricing and design review.
Detailed design to follow.

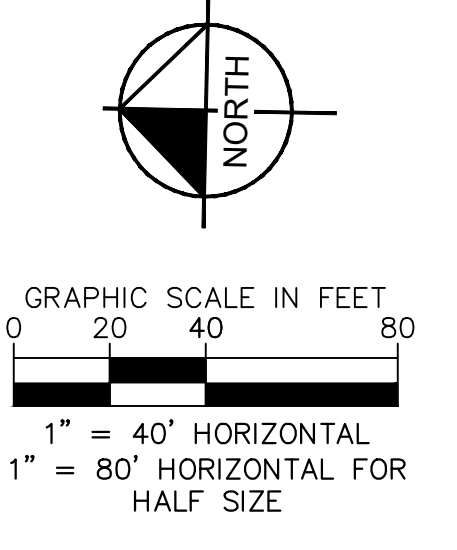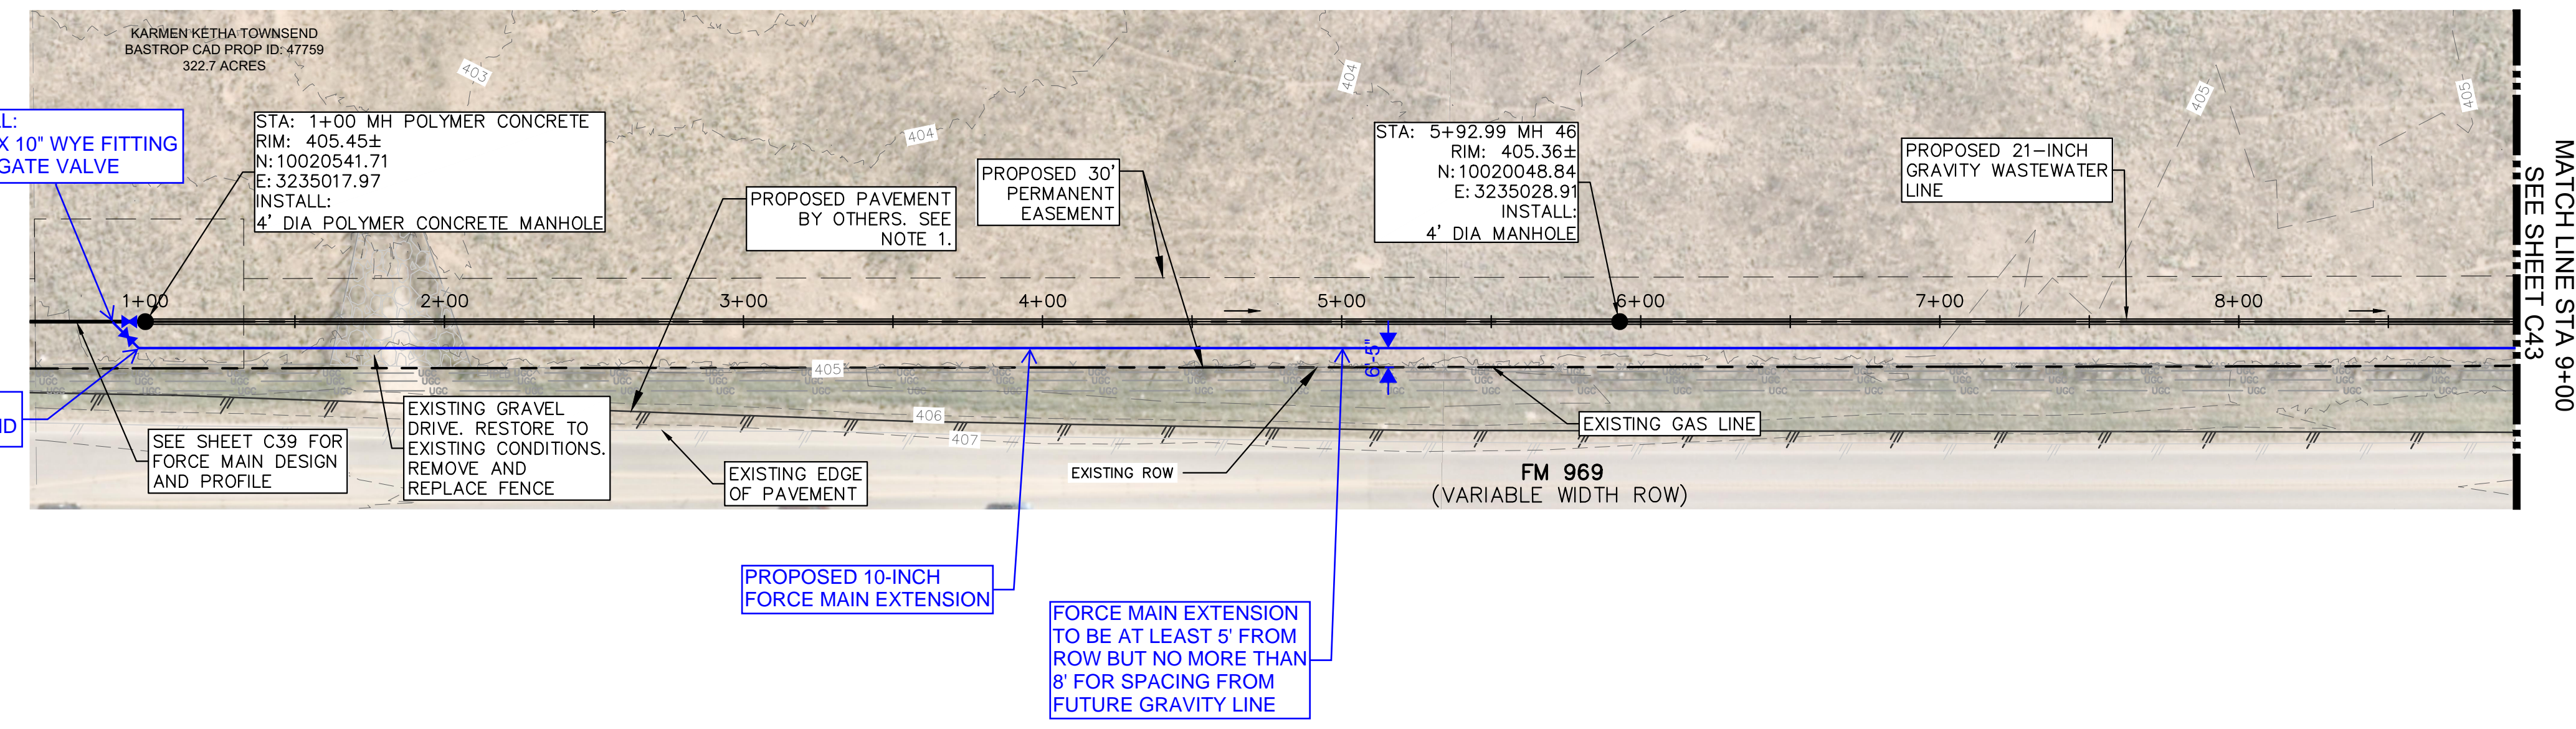

SHEET NOTES:
1. COLONY DEVELOPMENT IMPROVEMENTS BY OTHERS. CONTRACTOR TO COORDINATE ACCESS AND SEQUENCING AS NEEDED.

1" = 4' VERTICAL
1" = 8' VERTICAL FOR HALF SIZE

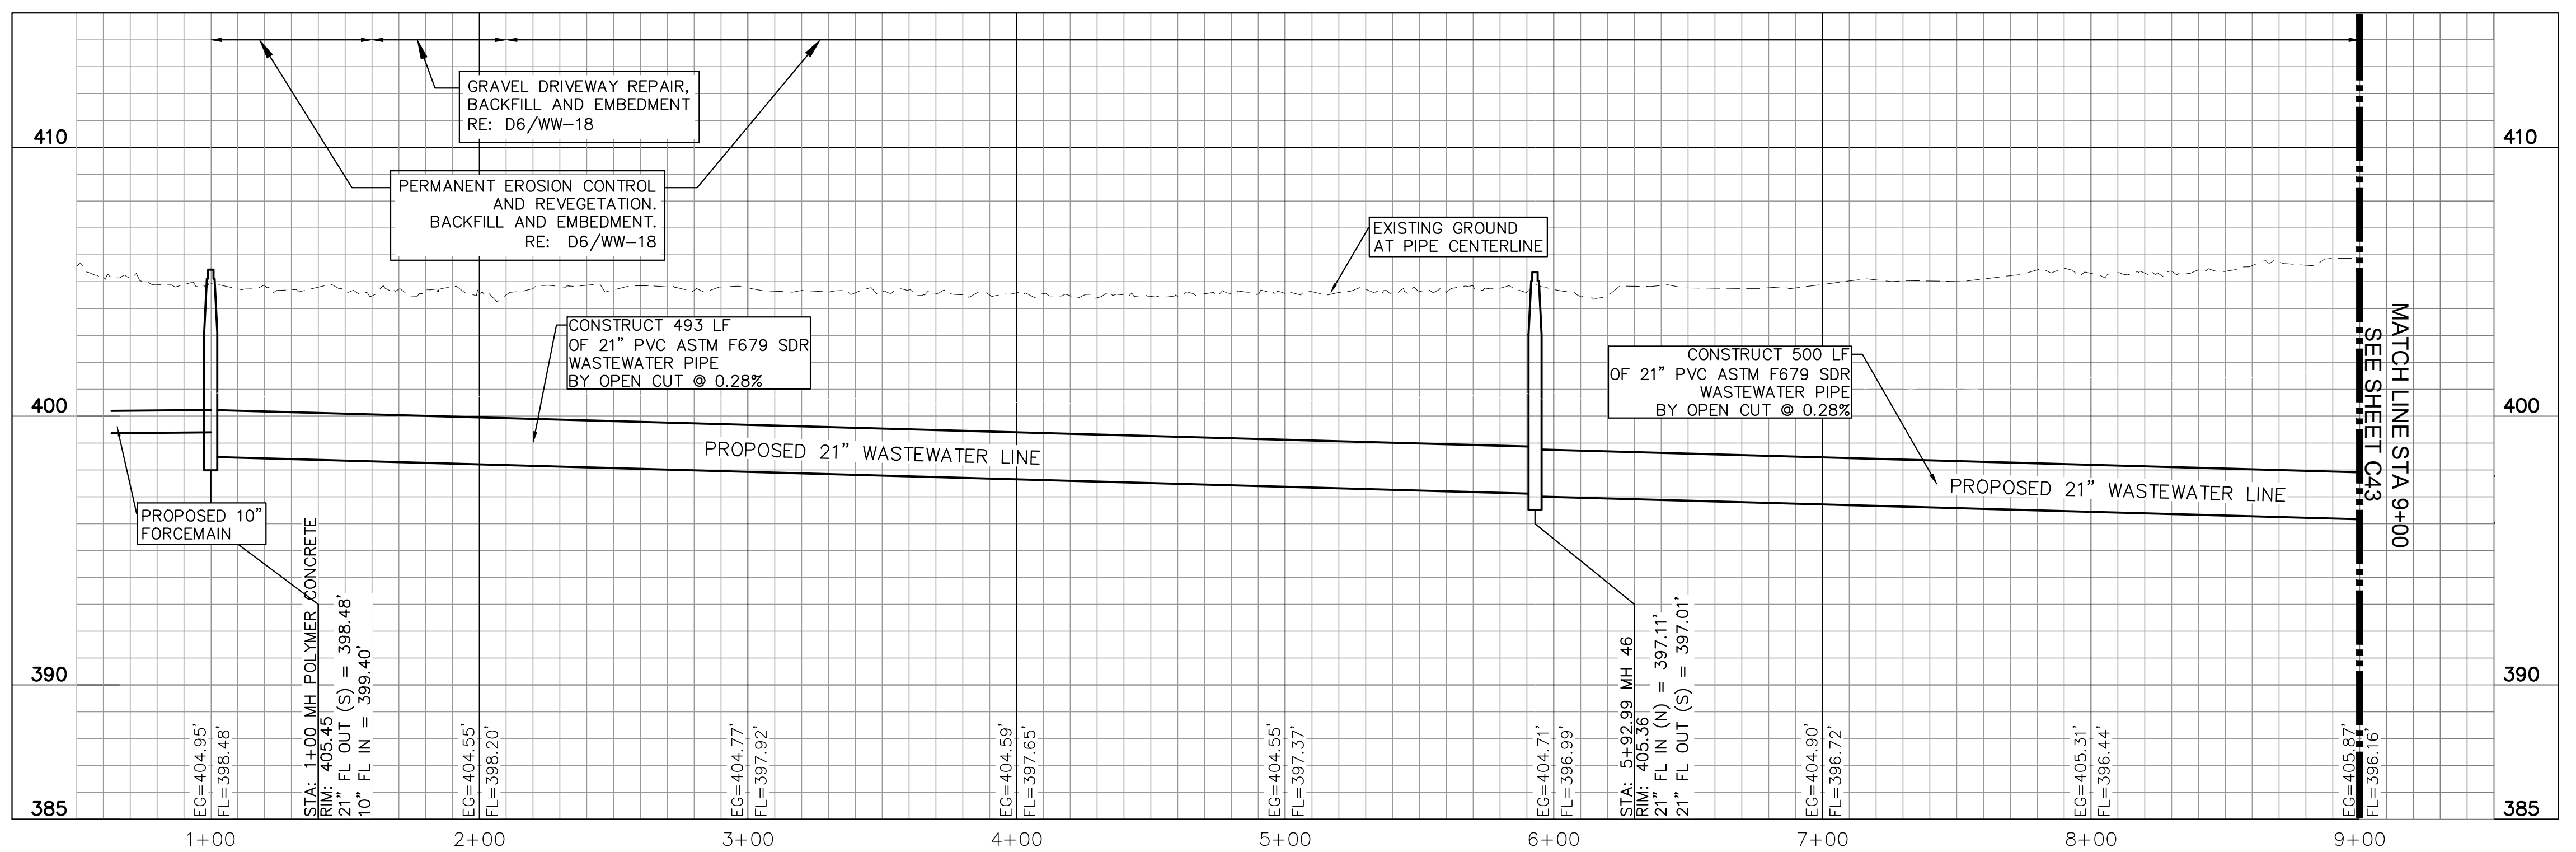

K:\SAU_WA_069268836- corix ww (gapped base)\CAD\plan\sheet\GRAVITY EXTENSION TO BLAKEY STA 17+00 - 25+00.dwg 7/18/2025 6:31 PM

Kimley»Horn
Firm No. F-928
5301 Southwest Pkwy, Building 2, Suite 100, Austin TX, 78725 P: 512-646-2237

By	
Date	
Revision	
No.	

**FM 969
WASTEWATER
EXTENSION**



**GRAVITY EXTENSION
TO BLAKEY STA 1+00
- 9+00**

Texas Water Utilities

DATE:	JULY 2025
DESIGN:	SAJ
DRAWN:	JCH, CJT, ALZ
CHECKED:	SRM
KHA NO.:	069268836


SHEET
C40

k:\SAU_MR\06926836-corix 969 ww (gapped base)\CAD\plansheets\GRAVITY EXTENSION TO BLAKEY STA 17+00 - 25+00.dwg 7/18/2025 5:34 PM

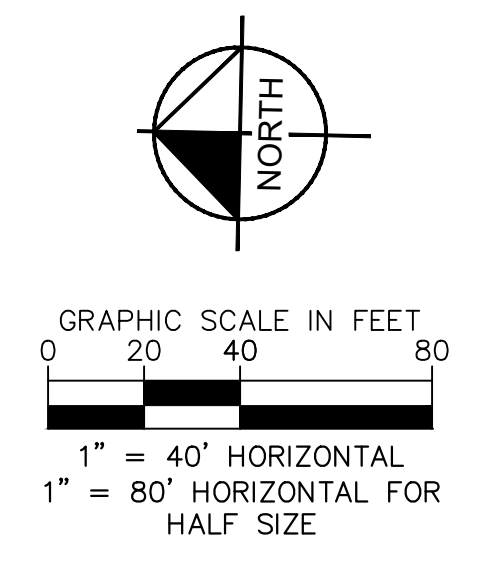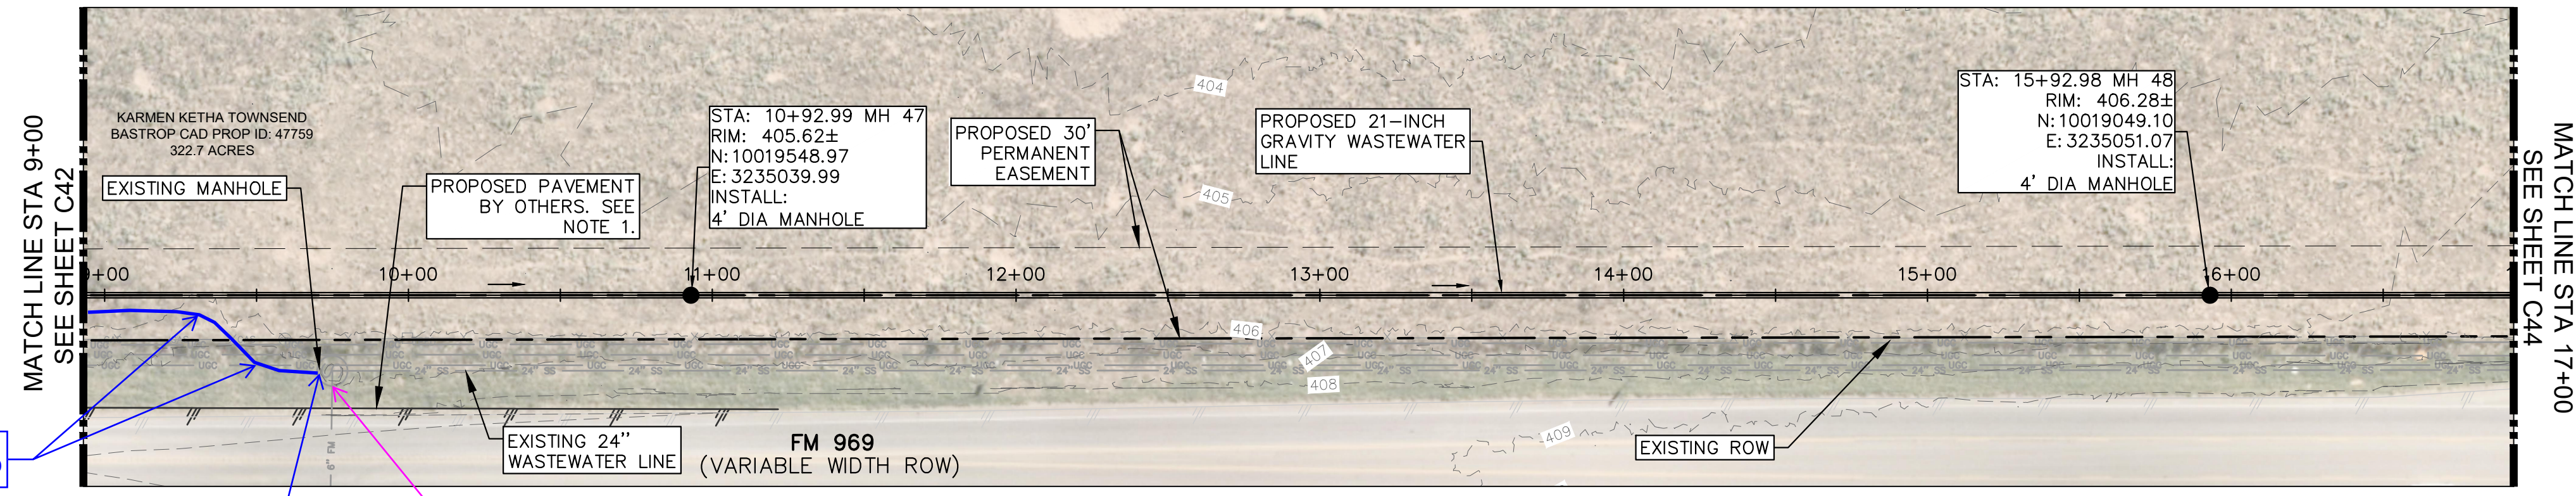

SHEET NOTES:
 1. COLONY DEVELOPMENT IMPROVEMENTS BY OTHERS. CONTRACTOR TO COORDINATE ACCESS AND SEQUENCING AS NEEDED.

Note:
 KH to process RULIS permit for MH connection
 Reynolds to pothole area to confirm connection is possible

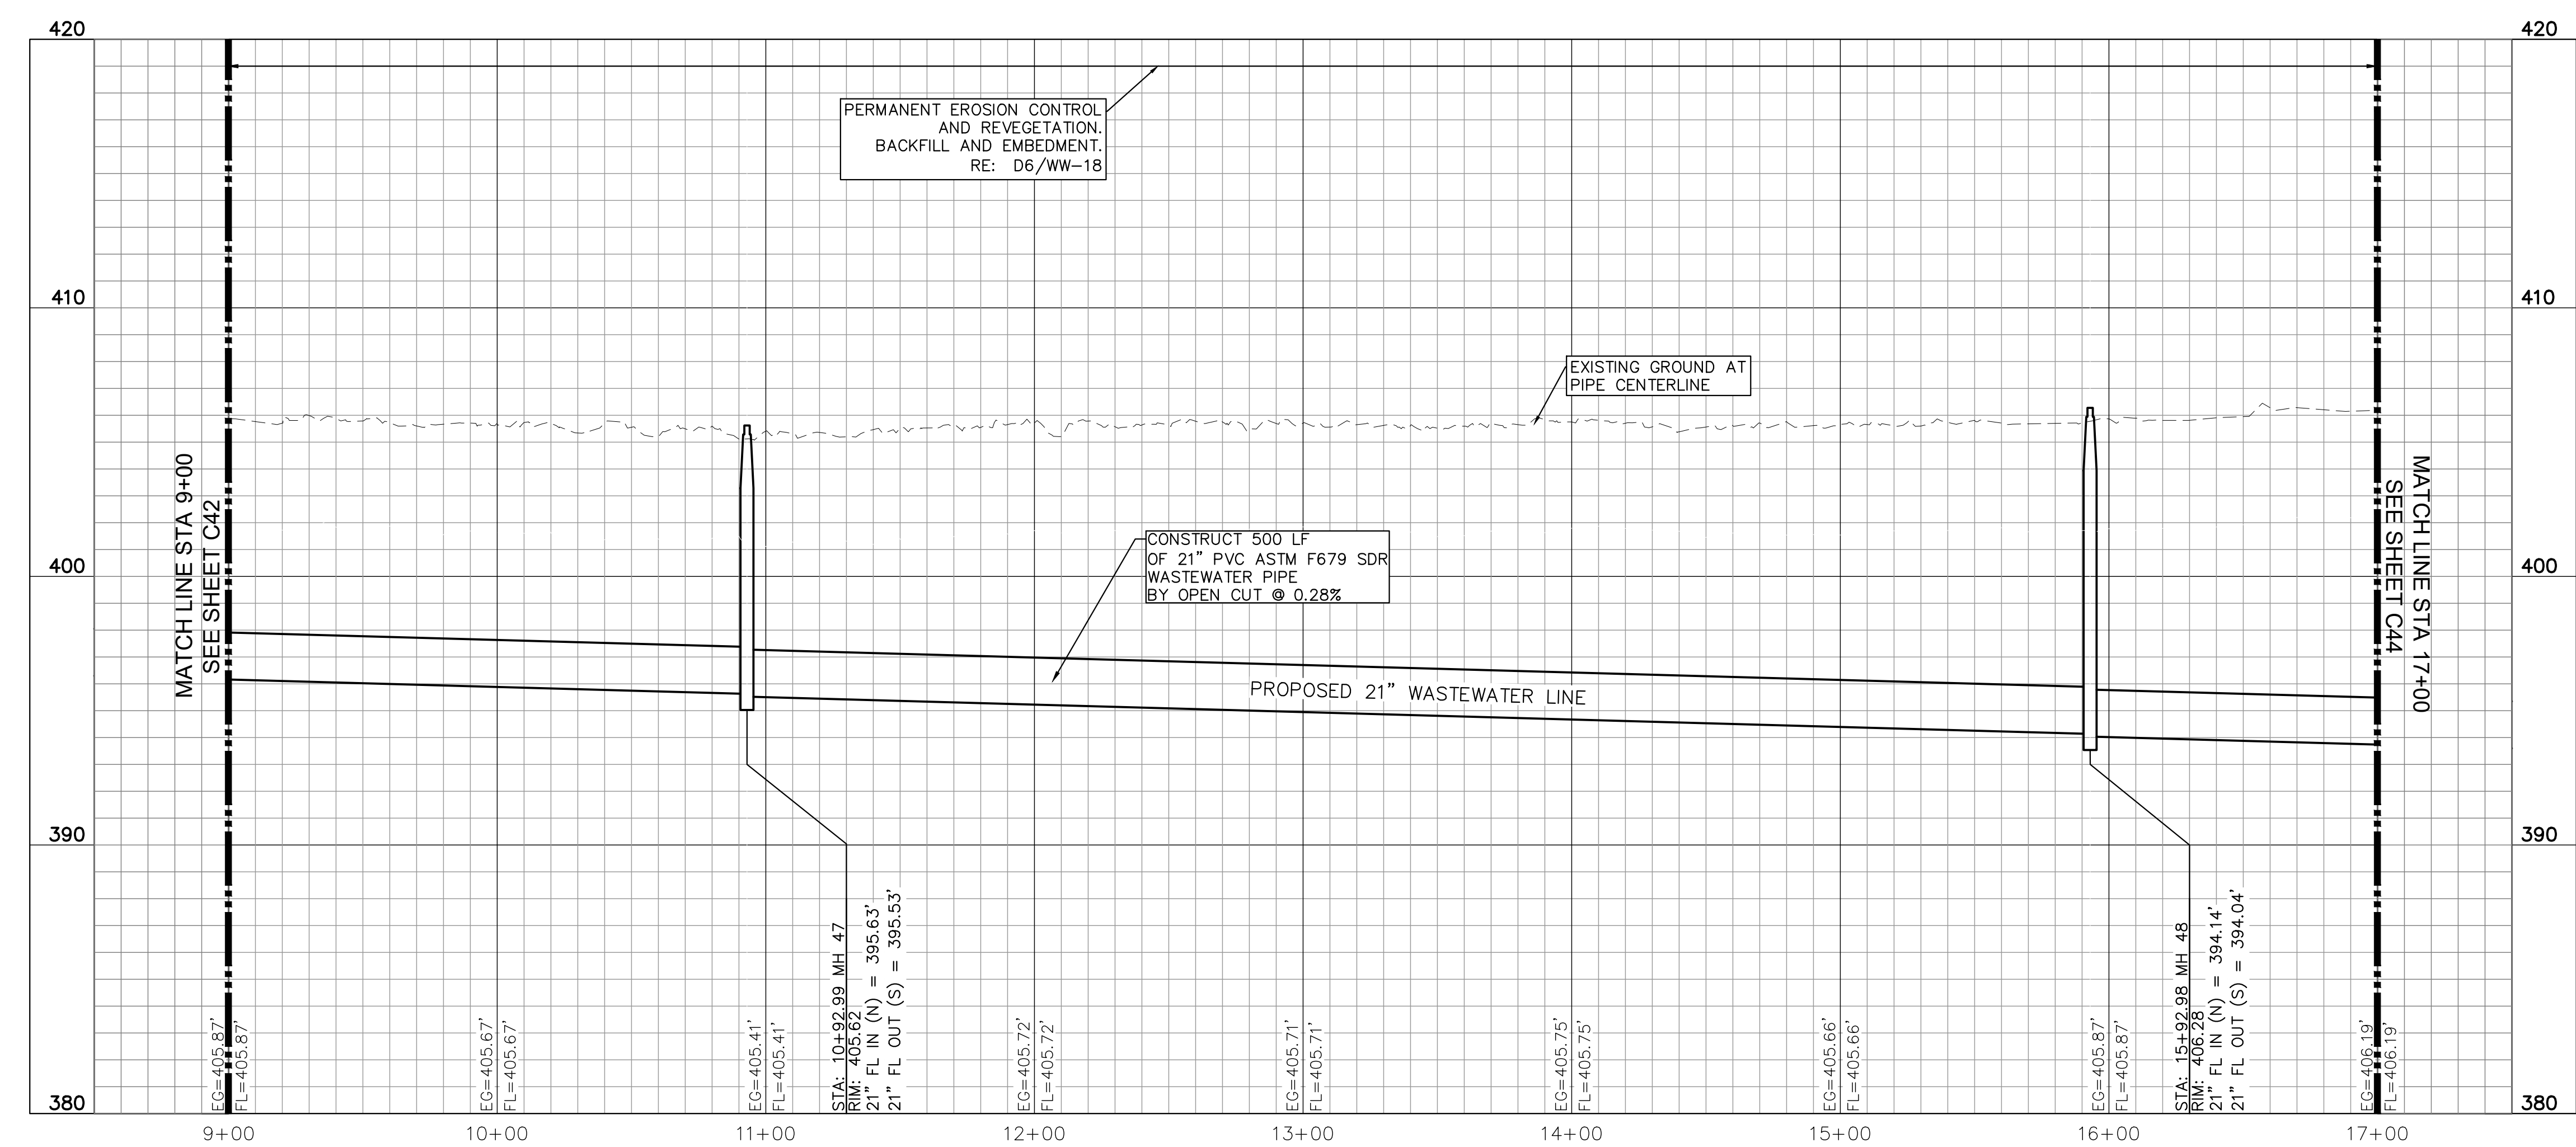

1" = 4' VERTICAL
 1" = 8' VERTICAL FOR HALF SIZE

Kimley»Horn
 Firm No. F-928
 5301 Southwest Pkwy, Building 2, Suite 100, Austin TX, 78725 P. 512-646-2237

By	Date
Revision	

**FM 969
 WASTEWATER
 EXTENSION**

**GRAVITY EXTENSION
 TO BLAKEY STA
 9+00-17+00**

Texas Water Utilities

DATE:	JULY 2025
DESIGN:	SAJ
DRAWN:	JCH, CJT, ALZ
CHECKED:	SRM
KHA NO.:	06926836